


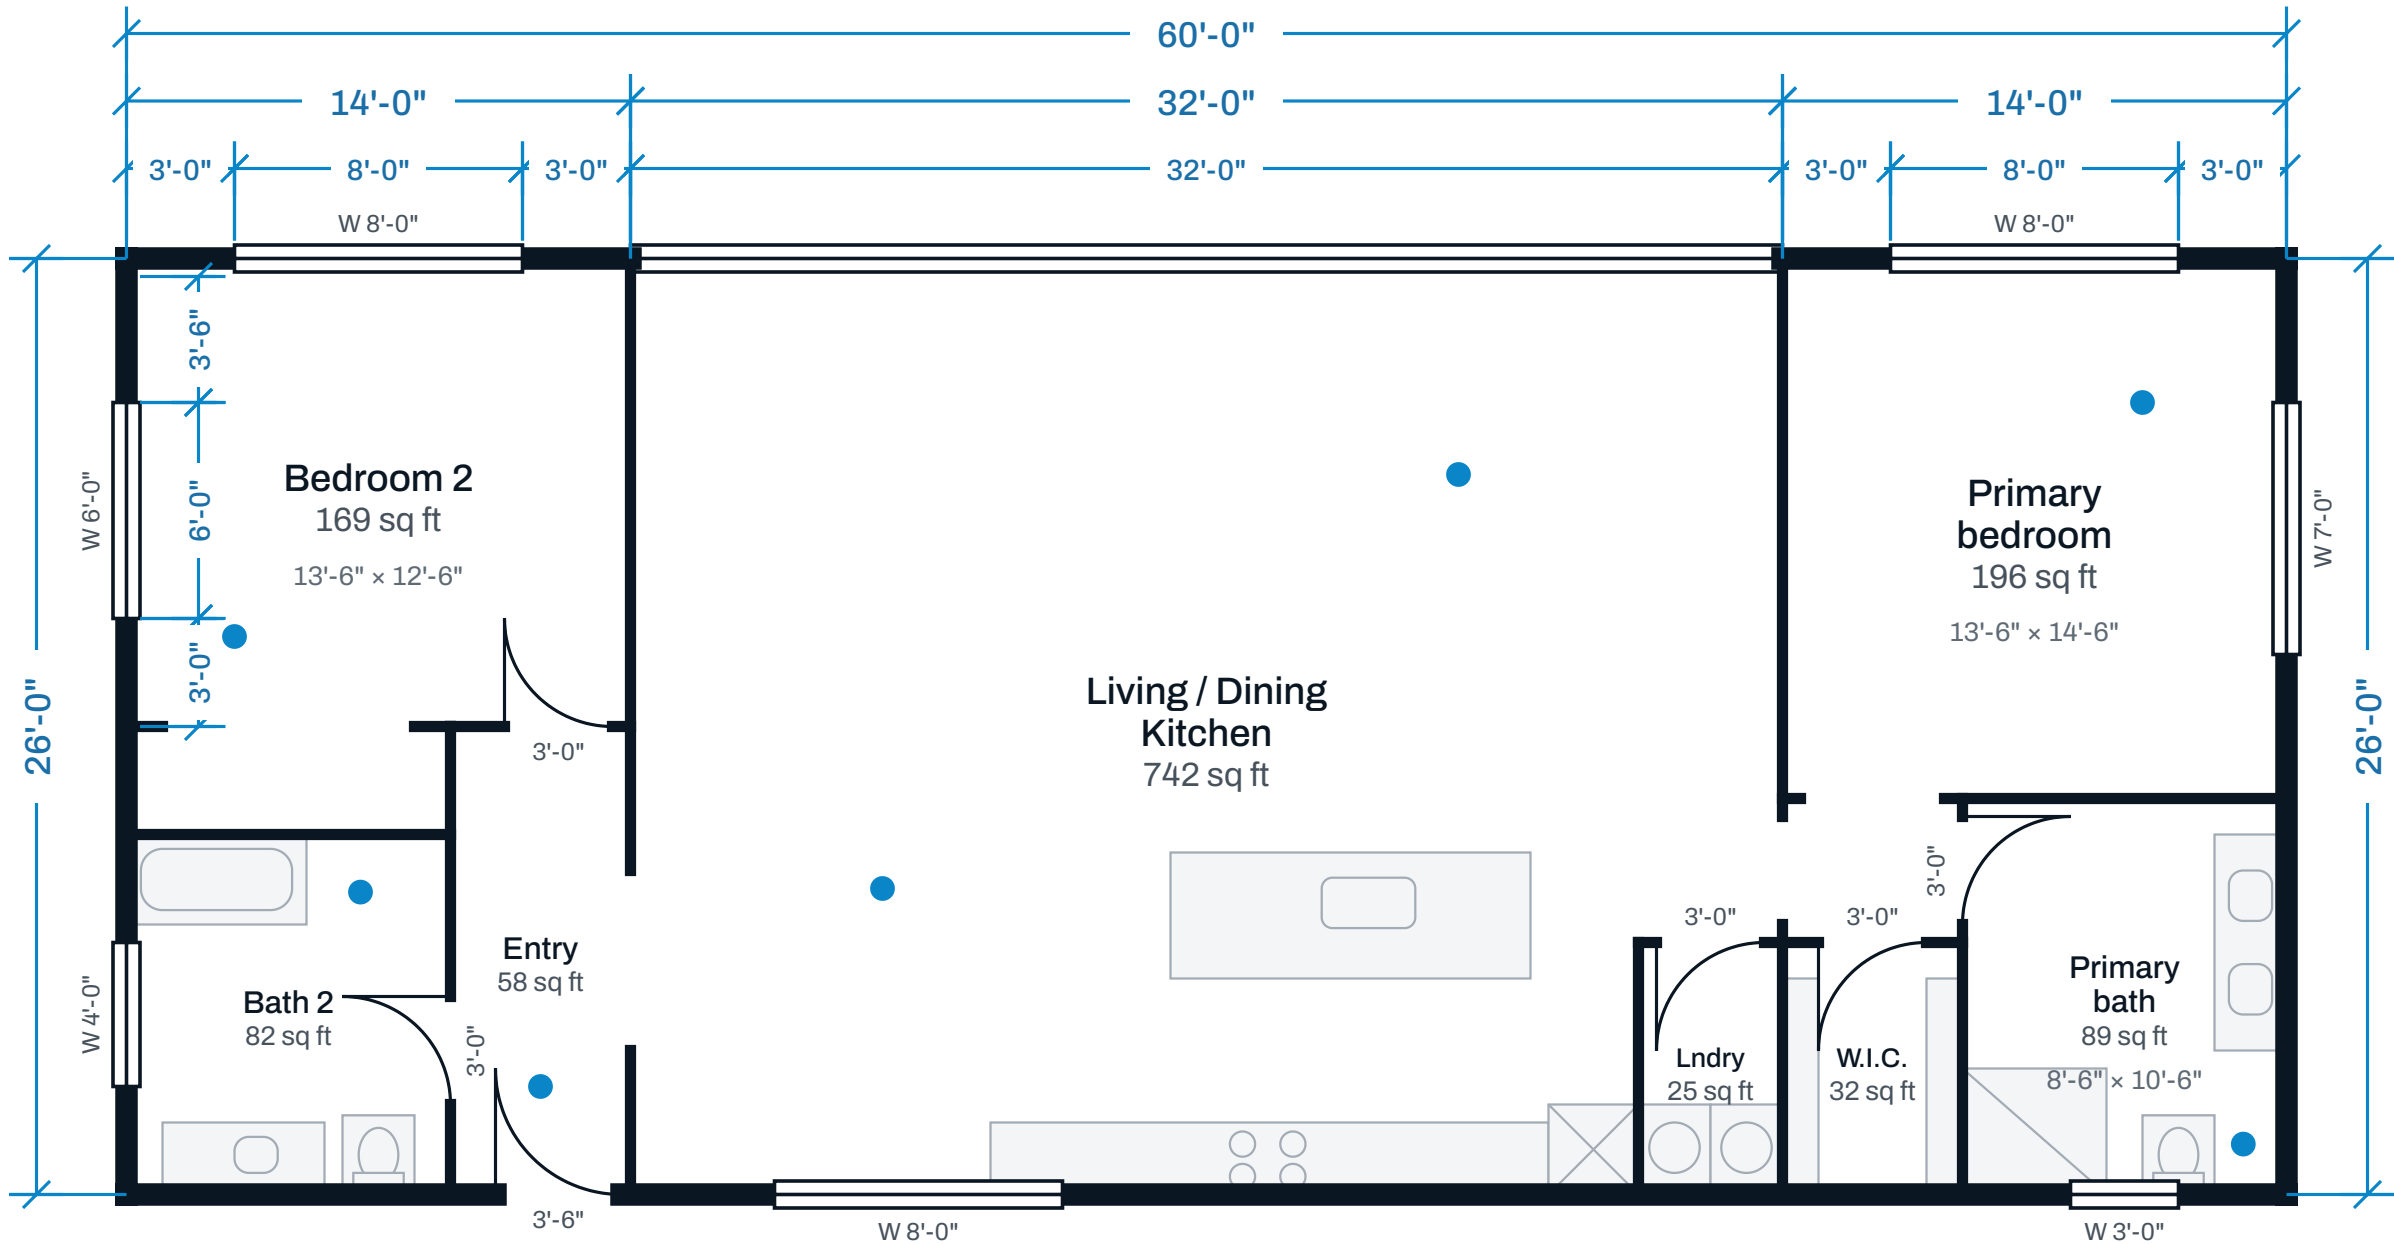

Sample as-built, level 1

2 bed, 2 bath, 60 × 26 ft (sample)

●

 7 scan positions

0

5

10 ft


Loose furniture not shown.

N

Sample drawing, not a real project

- General notes
- On this sample, overall dimensions are to the outside face of the exterior walls. Your quote confirms how areas are reported.
 - Exterior wall thickness is measured through door and window openings.
 - Drawn from a 3D scan made on the scan date shown, rated about ±20 mm at 10 m. Verify critical dimensions on site.
 - Conditions hidden behind finishes, furniture or storage are not shown.

Sample drawing, not a real project. Verify critical dimensions on site.

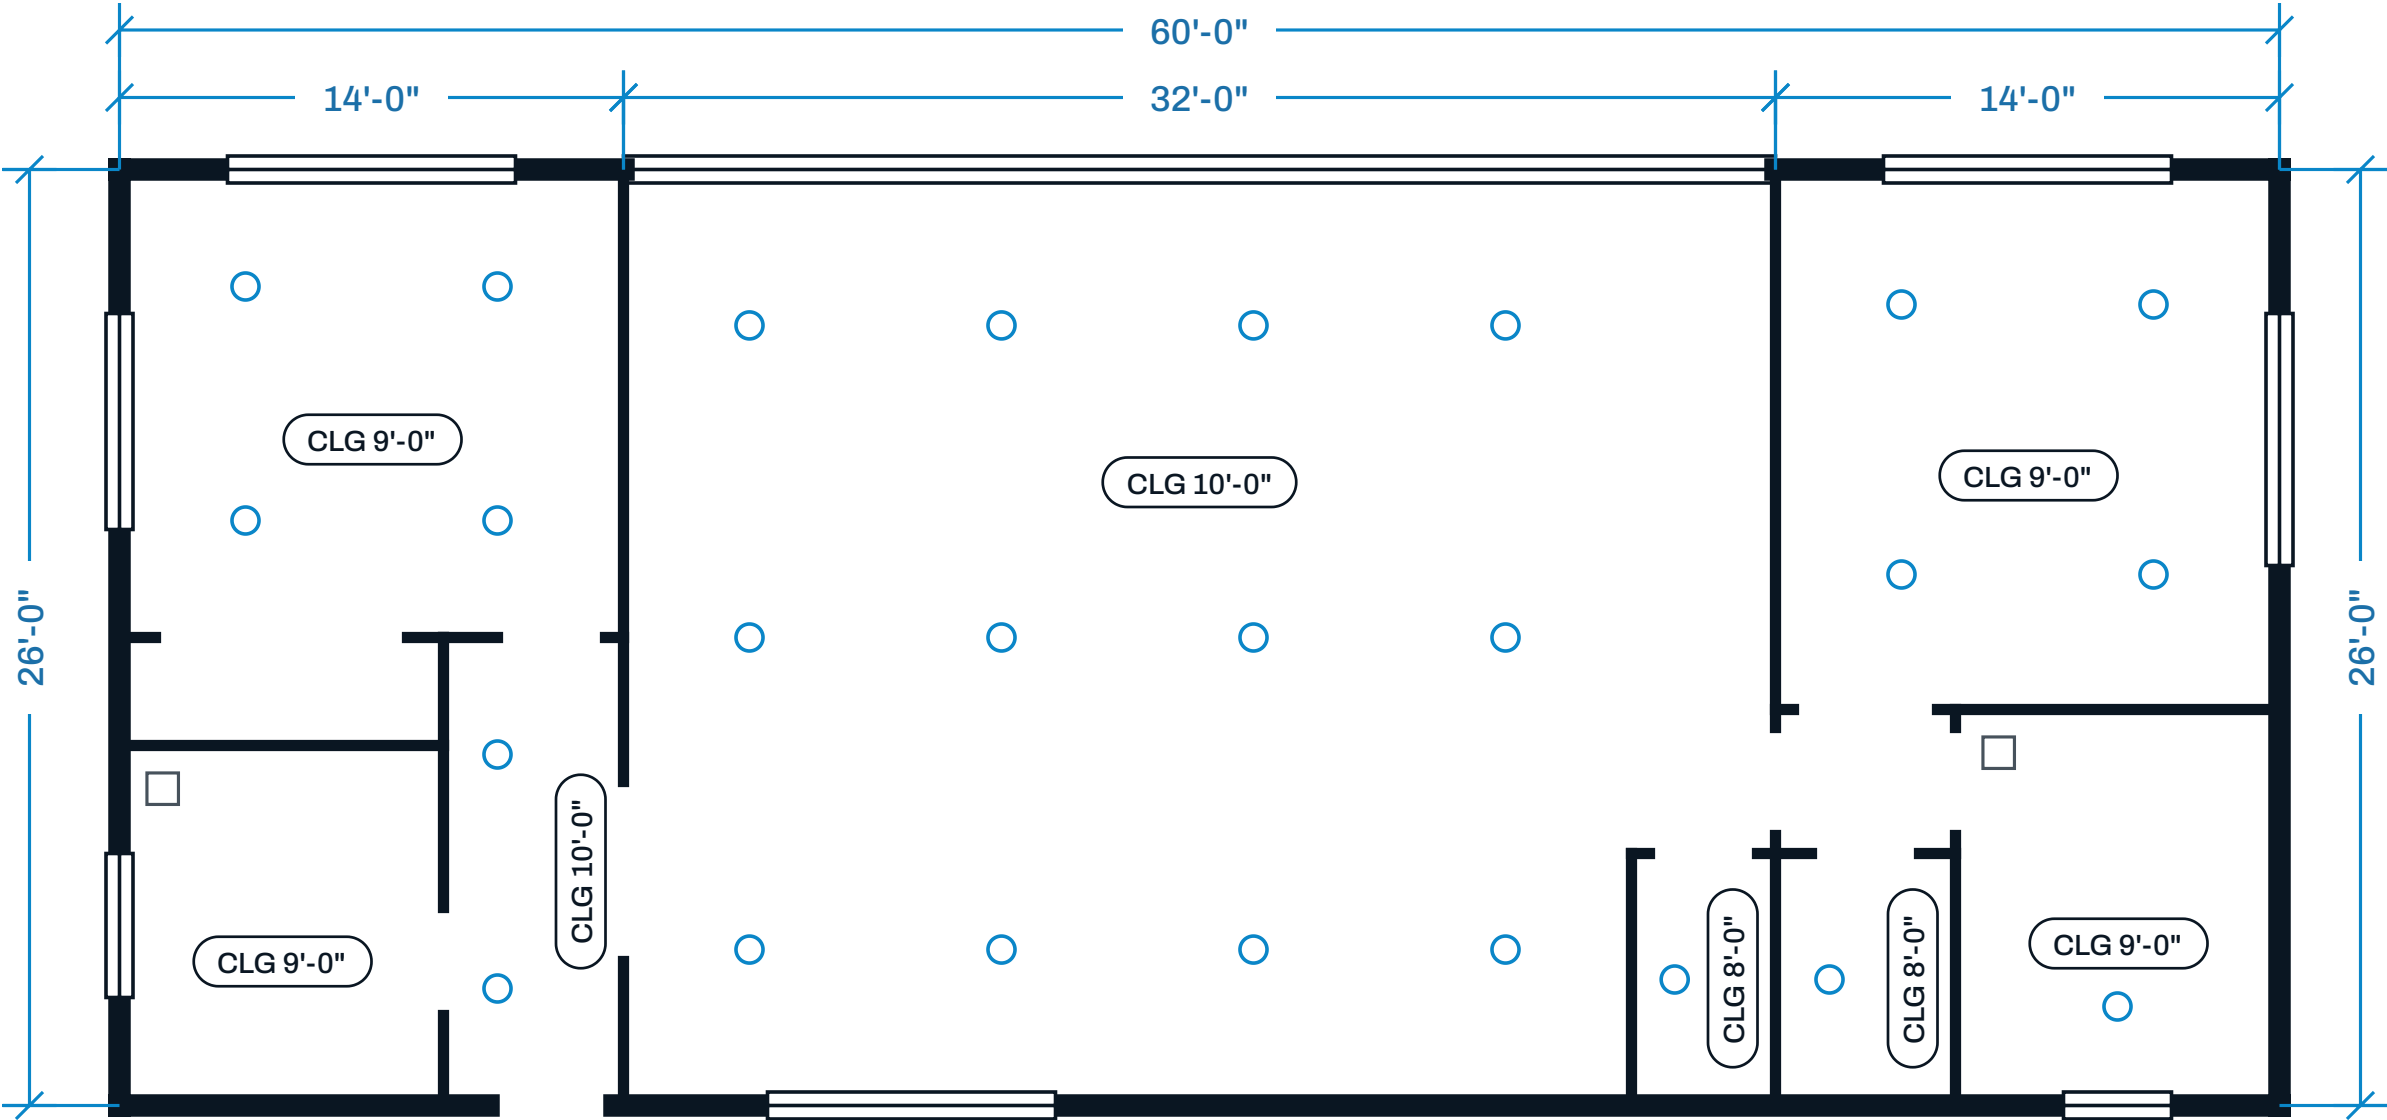

Sample drawing, not a real project

Sample reflected ceiling plan

2 bed, 2 bath, 60 × 26 ft (sample)

Recessed light

Bath fan

0

5

10 ft

N

Project
2140 Sample Ave (sample)
One-story house, 2 bed, 2 bath, 60 × 26 ft

Drawn from
3D scan, Realsee Galois M2 LiDAR
Rated about ±20 mm at 10 m

Scan date
Feb 20, 2026

Scale
3/16" = 1'-0" on the 17 × 11 in sheet

Issue
Sample set, Feb 2026

- General notes
- On this sample, overall dimensions are to the outside face of the exterior walls. Your quote confirms how areas are reported.
 - Exterior wall thickness is measured through door and window openings.
 - Drawn from a 3D scan made on the scan date shown, rated about ±20 mm at 10 m. Verify critical dimensions on site.
 - Conditions hidden behind finishes, furniture or storage are not shown.

Sample drawing, not a real project. Verify critical dimensions on site.


Sheet title
Reflected ceiling plan
Included in: As-Built

A-102

Sample drawing, not a real project


North elevation (glass wall), sample

Scale 1/8" = 1'-0"

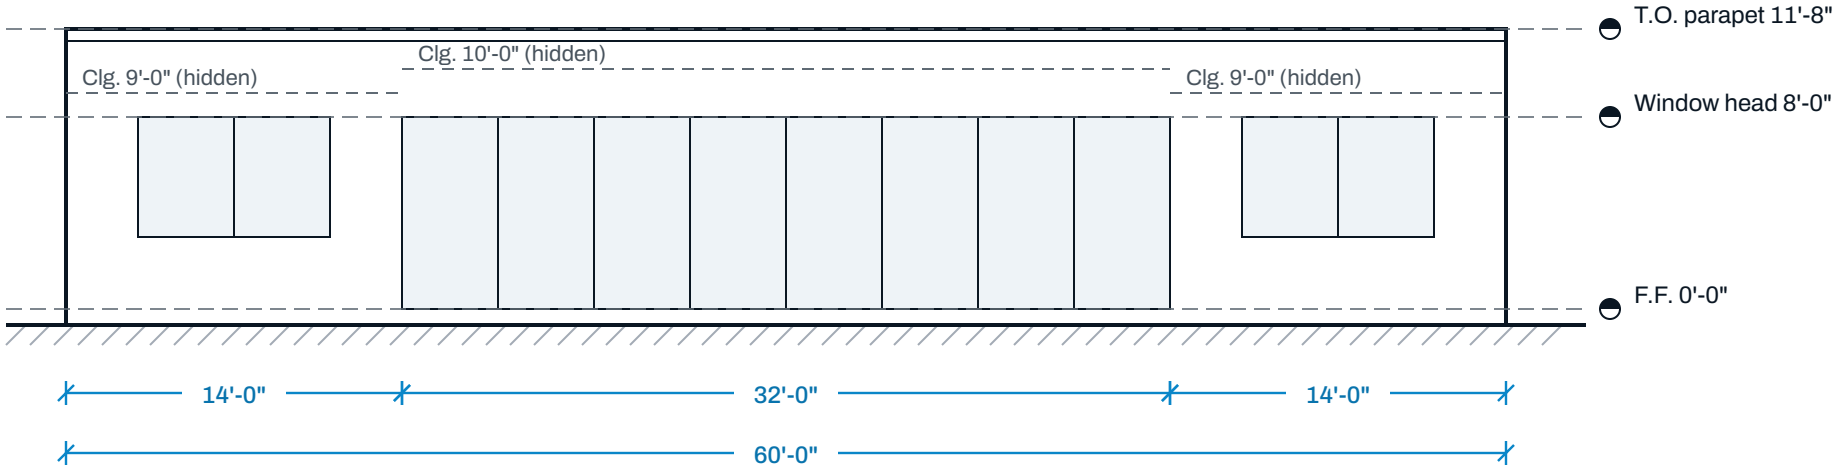

Section through the great room, looking east

Scale 1/4" = 1'-0"

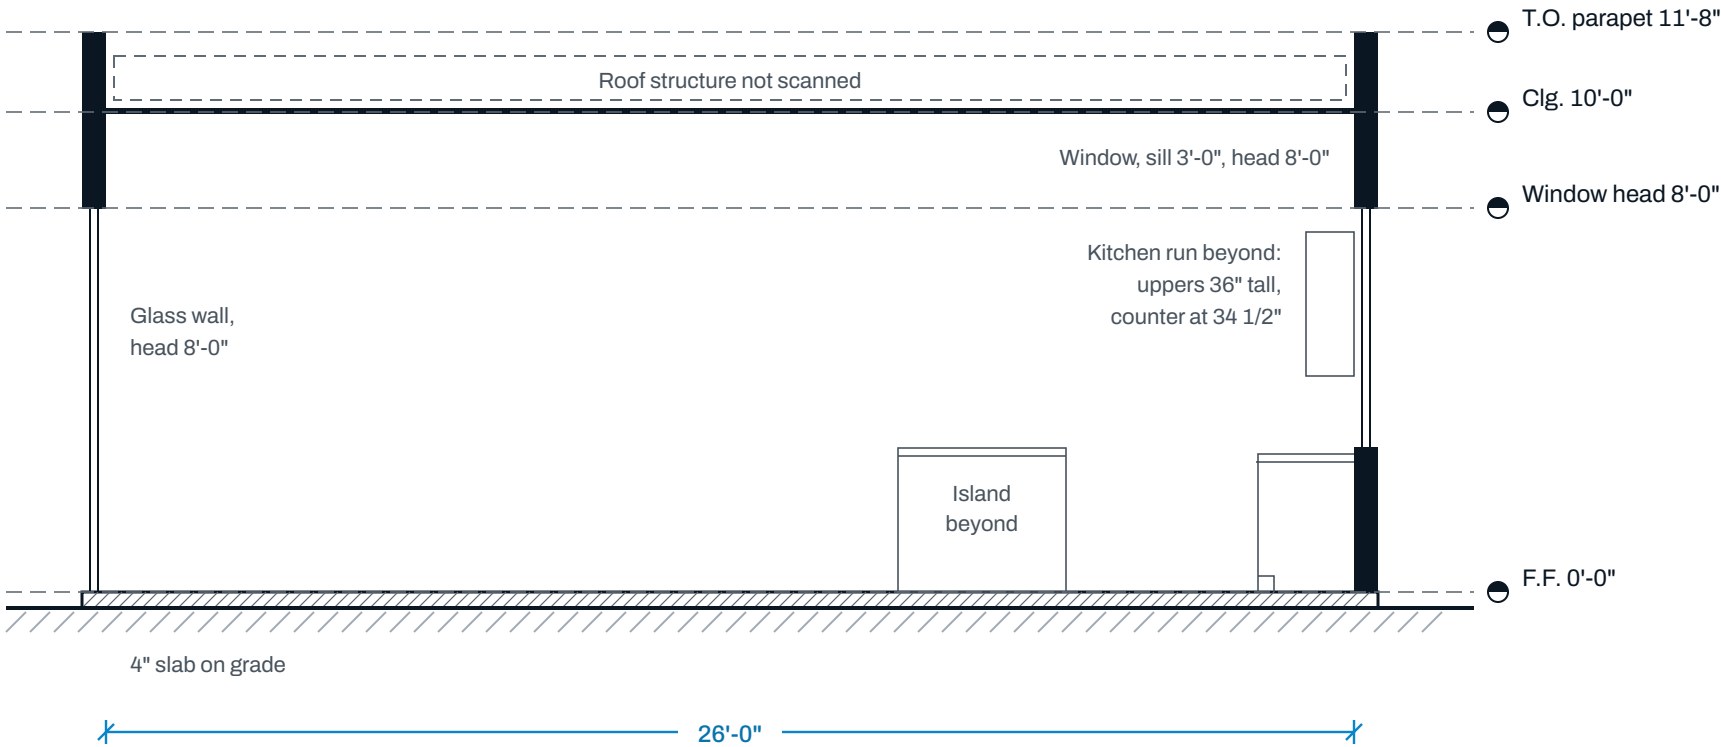

Replicasa 3D, sample

Project
2140 Sample Ave (sample)
One-story house, 2 bed, 2 bath, 60 × 26 ft

Drawn from
3D scan, Realsee Galois M2 LiDAR
Rated about ±20 mm at 10 m

Scan date
Feb 20, 2026

Scale
As noted, on the 17 × 11 in sheet

Issue
Sample set, Feb 2026

Sample drawing, not a real project. Verify critical dimensions on site.

Sheet title
North elevation and section
Included in: As-Built Pro